The information contained in this drawing is the confidential property of Platinum Energy Services Corp. No part thereof shall be reproduced or communicated to a third party without written authorization from Platinum Energy Services Corp.

BILL OF MATERIAL

MARK	QTY	MEMBER	LENGTH(mm)	WIDTH(mm)	MATERIAL	WEIGHT(kg)	HEAT#
1	3	C4x5.4	241		G-44W	5.81	
2	3	C6x8.2	153		G-44W	5.60	
3	3	C6x8.2	255		G-44W	9.33	
4	2	C6x8.2	1958		G-44W	47.79	
TOTAL WEIGHT: 68.53							

*ALL BOM ITEMS DO NOT INCLUDE WELD GAP

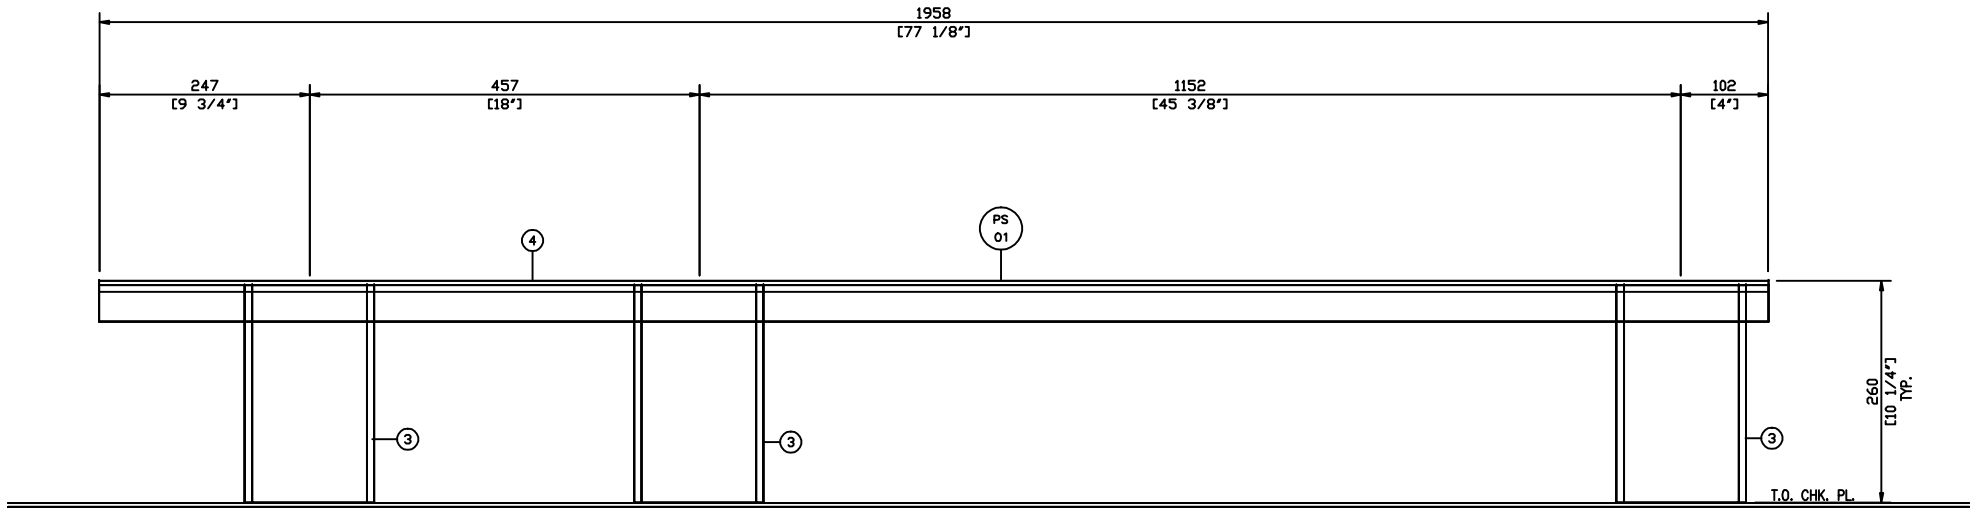

PS-01 DETAIL
(1:4)

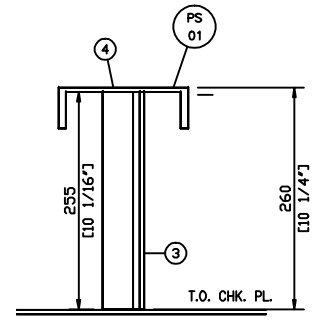

'A-A' VIEW
(1:4)

ELEVEN (11) UNITS REQUIRED

21188-SKD-02
21189-SKD-02
21190-SKD-02
21191-SKD-02
21192-SKD-02
21193-SKD-02
21194-SKD-02
21195-SKD-02
21196-SKD-02
21197-SKD-02
21198-SKD-02

BOM FOR ONE(1) UNIT ONLY

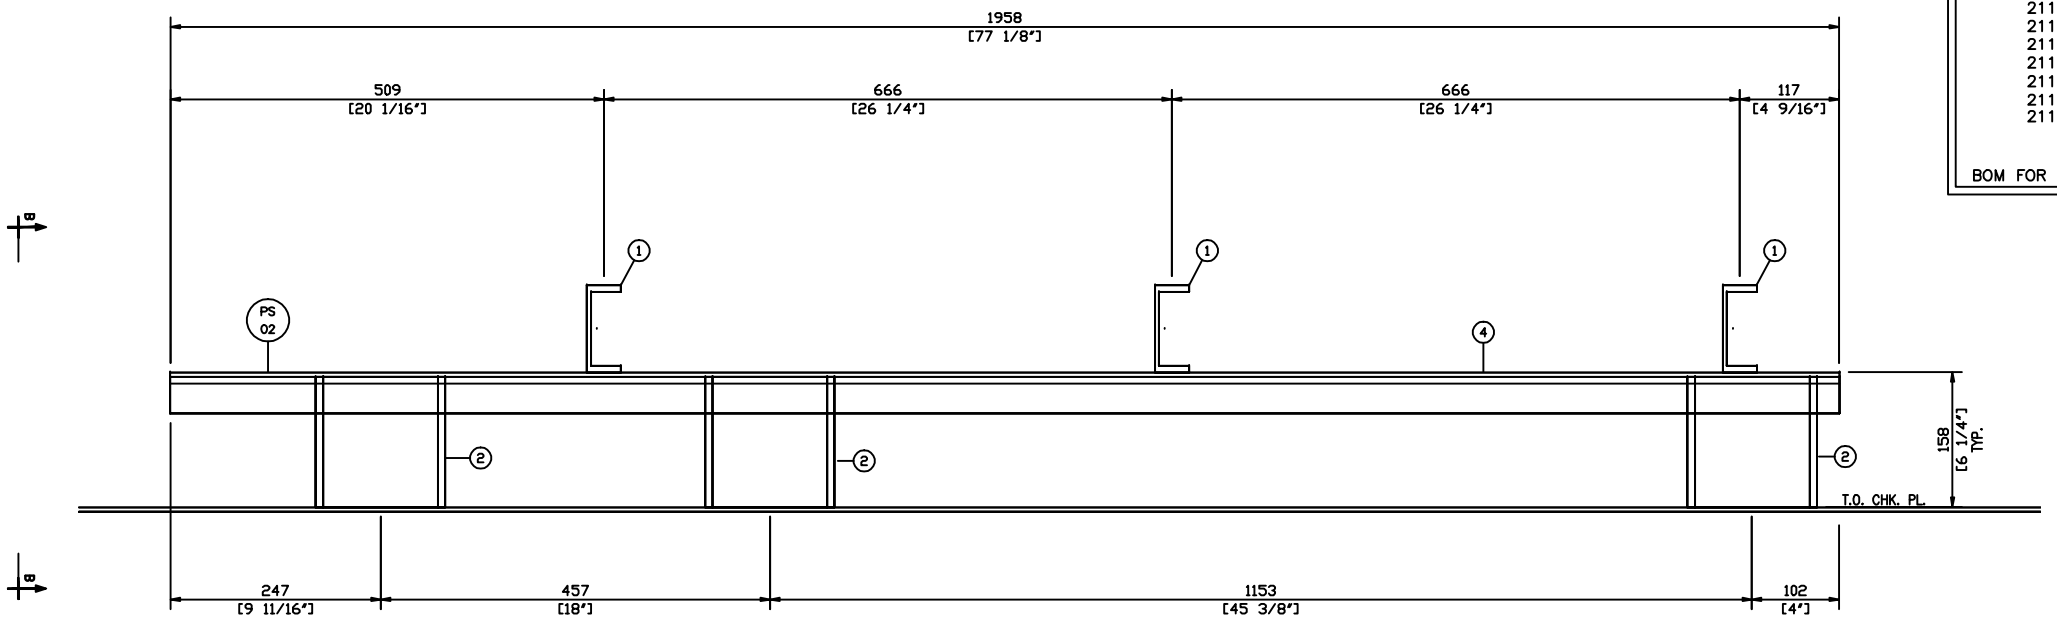

PS-02 DETAIL
(1:4)

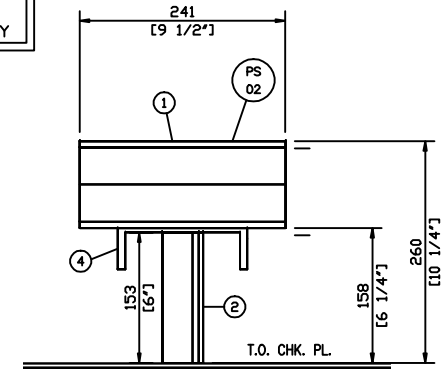

'B-B' VIEW
(1:4)

NOTES:
1. SEE NOTES ON DWG SKD-01.
2. FILLET WELDS TO BE 1/4" UNLESS NOTED OTHERWISE.

REFERENCE DRAWINGS

REV	DESCRIPTION	BY	DATE	CHK'D	APP'D
1	AS BUILT	EB	13-07-30	BX	RWS
0	ISSUED FOR CONSTRUCTION	LL	13-06-12	BX	RWS
A	ISSUED FOR APPROVAL	LL	13-05-28	BX	RWS

ENGINEER'S STAMP

DRAWN BY	LL	13-05-28
CHK'D BY	BX	13-05-28
APP'D BY	RWS	13-05-28
CAD REF	21188-SKD-02.DWG	SCALE AS SHOWN

PLATINUM Energy Services Corp.
CALGARY, ALBERTA

CLIENT: PROGRESS ENERGY CANADA LTD.

TITLE: 24"x7'-6" 1440 PSI 3PH DRESS 2PH TEST SEPARATOR c/w PROVISIONS FOR 6 WELL HEADER - SUPPORT DETAIL

JOB NO.	DRAWING NO.	REV
21188-21198	21188-SKD-02	1

S:\TRANSFERS\UNIT NUMBER'S\21000\21196-21198\21196-SKD-01.DWG